



SECOND FLOOR PLAN



2ND FLOOR AREAS
UNIT 2 1504 S.F.

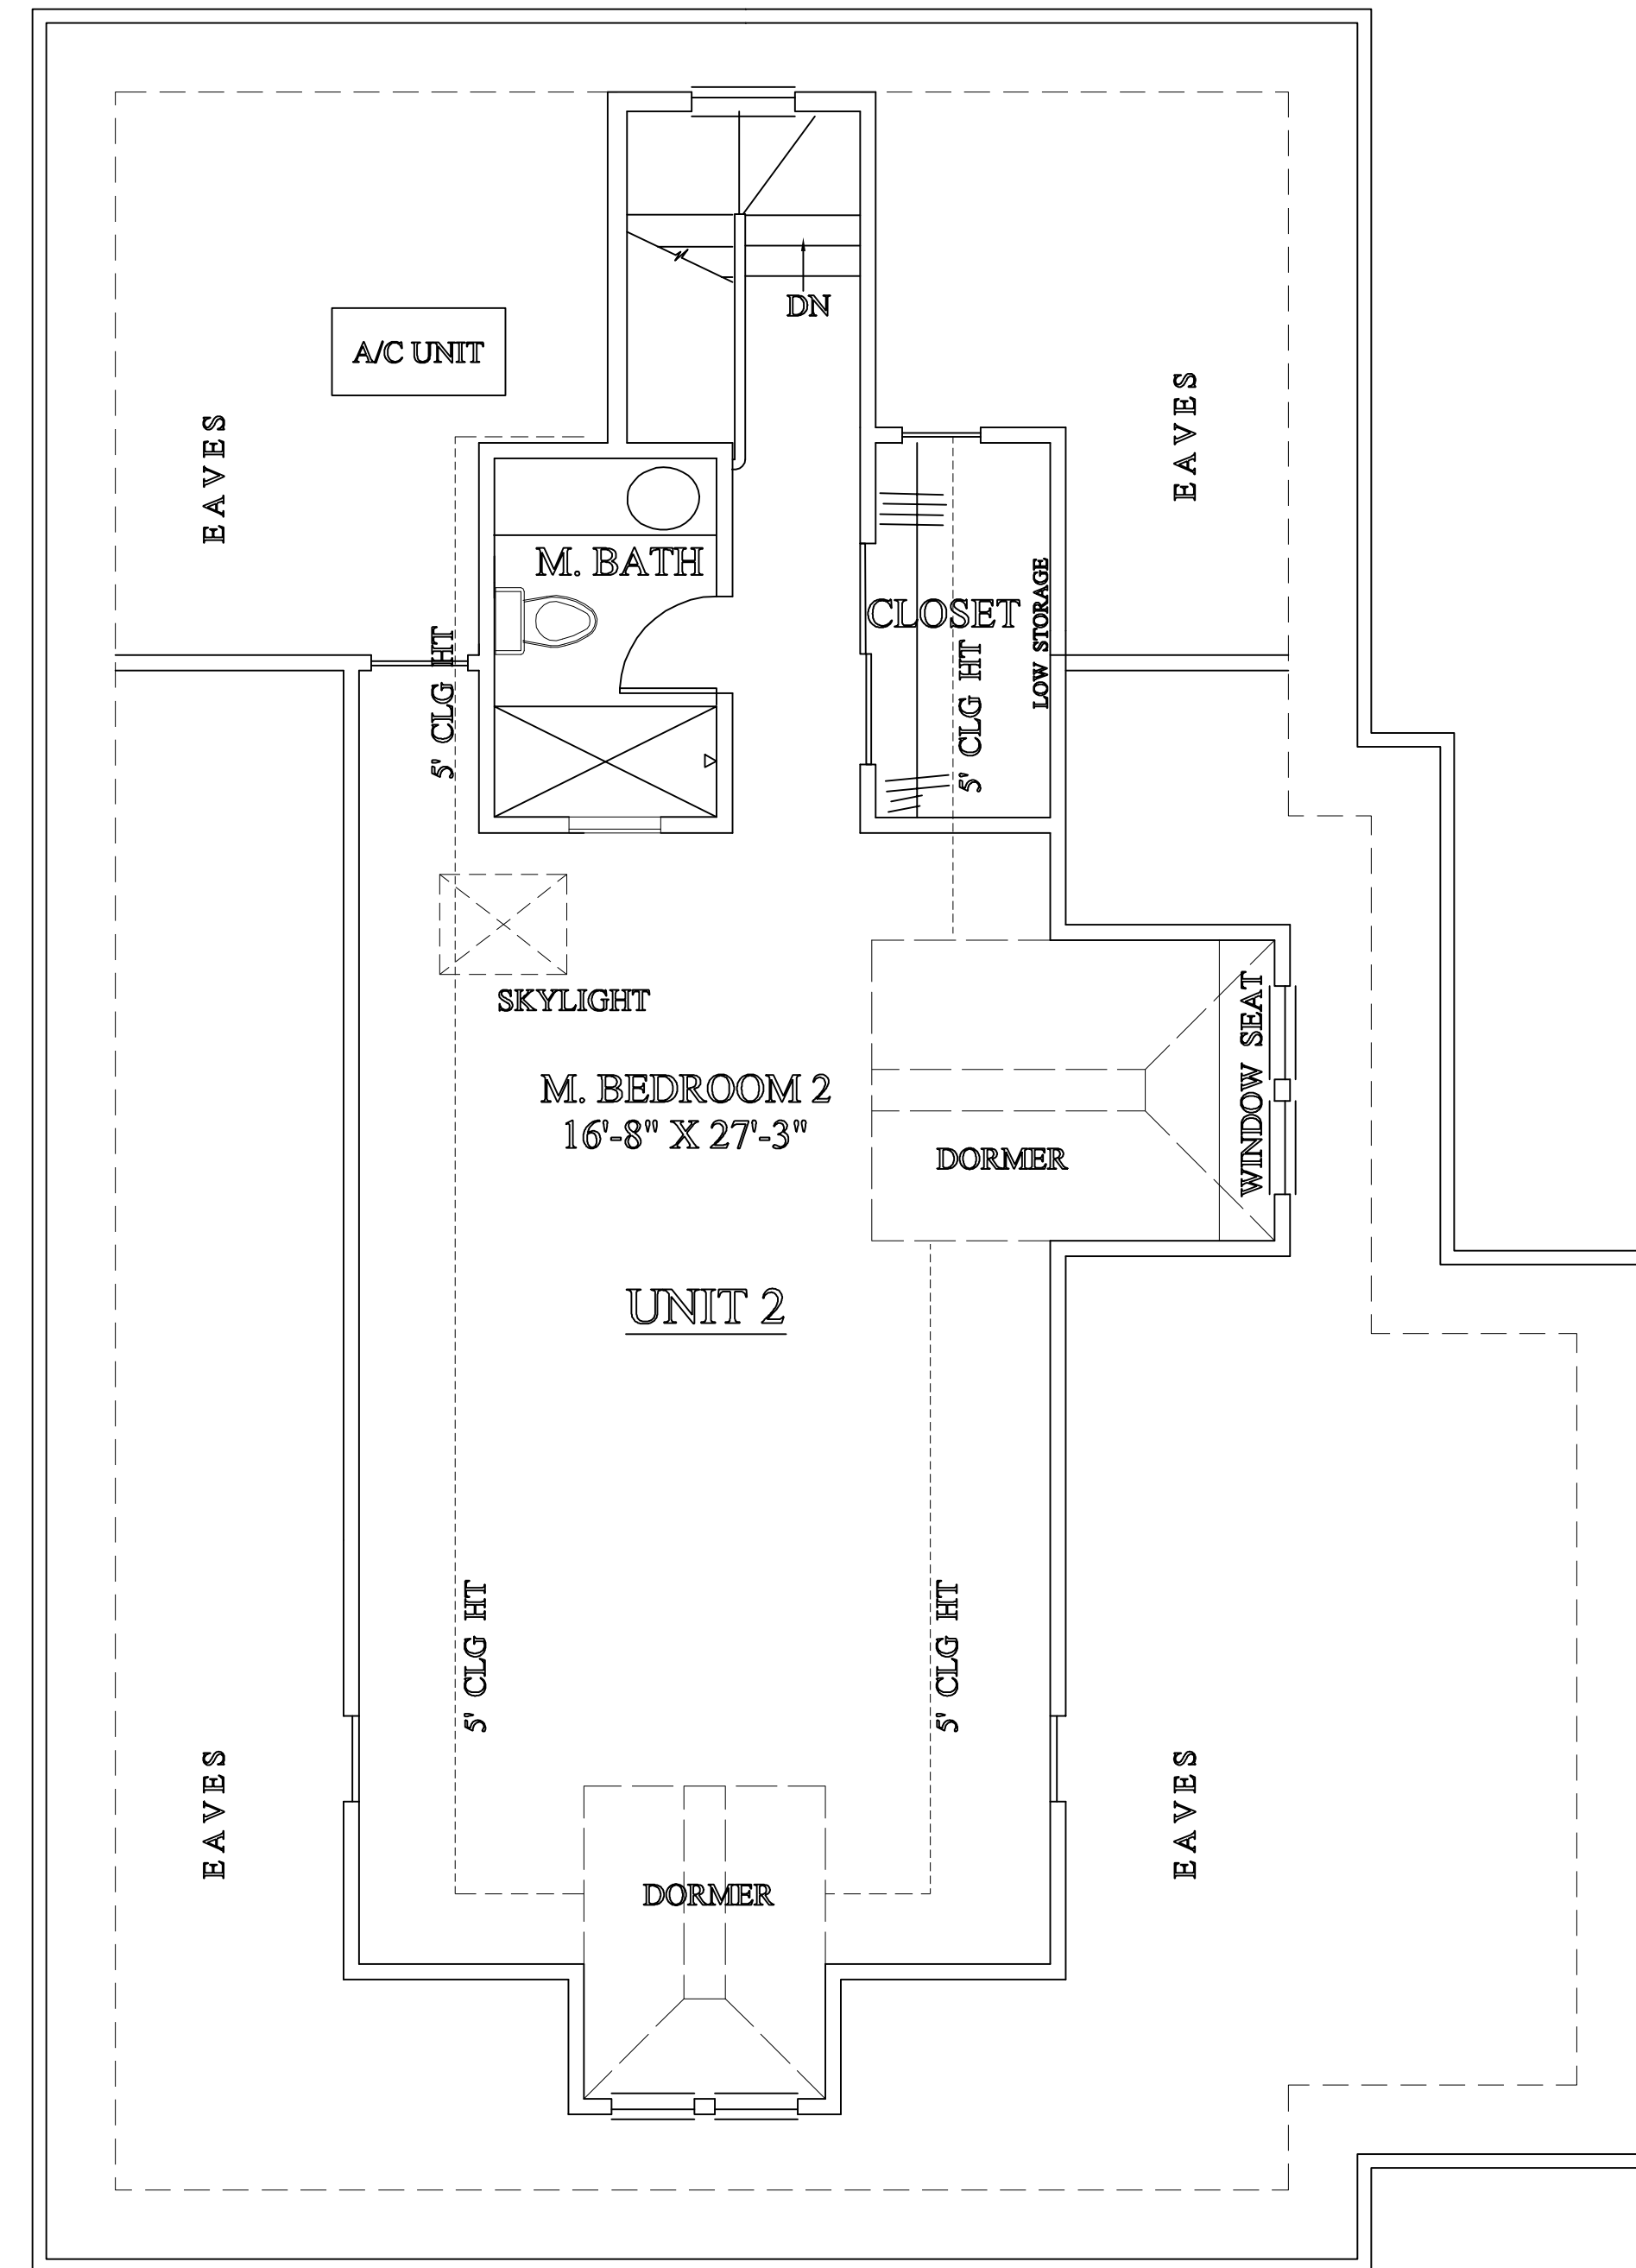

THIRD FLOOR PLAN

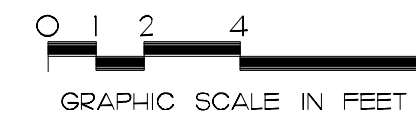

3RD FLOOR AREAS
UNIT 2 685 S.F.
OF WHICH 155 S.F. IS
UNDER 5' HIGH

RESERVED FOR REGISTRY

114-116 BYNNER STREET CONDOMINIUM
114-116 BYNNER STREET
JAMAICA PLAIN, MA 02130

"I CERTIFY THAT THIS PLAN FULLY AND ACCURATELY DEPICTS THE LOCATION AND DIMENSIONS OF THE BUILDING AS BUILT AND FULLY LISTS THE UNITS CONTAINED THEREIN."

DATE _____

0414CONDO.DWG

"I CERTIFY THAT THIS PLAN HAS BEEN PREPARED IN CONFORMITY WITH THE RULES AND REGULATIONS OF THE REGISTERS OF DEEDS OF THE COMMONWEALTH OF MASSACHUSETTS,"

DATE _____

I CERTIFY THAT THIS PLAN FULLY AND ACCURATELY DEPICTS THE LAYOUT, LOCATION, UNIT NUMBERS AND DIMENSIONS OF THE UNITS NUMBERS 1 & 2 INCLUSIVE, IN BUILDING NUMBERED 114-116 BYNNER STREET, AS BUILT.

DATE _____

DRAWING NO 2 OF 3

DRAWN BY KUNZ ASSOCIATES
38 GREENWICH PARK
BOSTON, MA 02118
617-267-1482